


EXHIBIT F

Beer

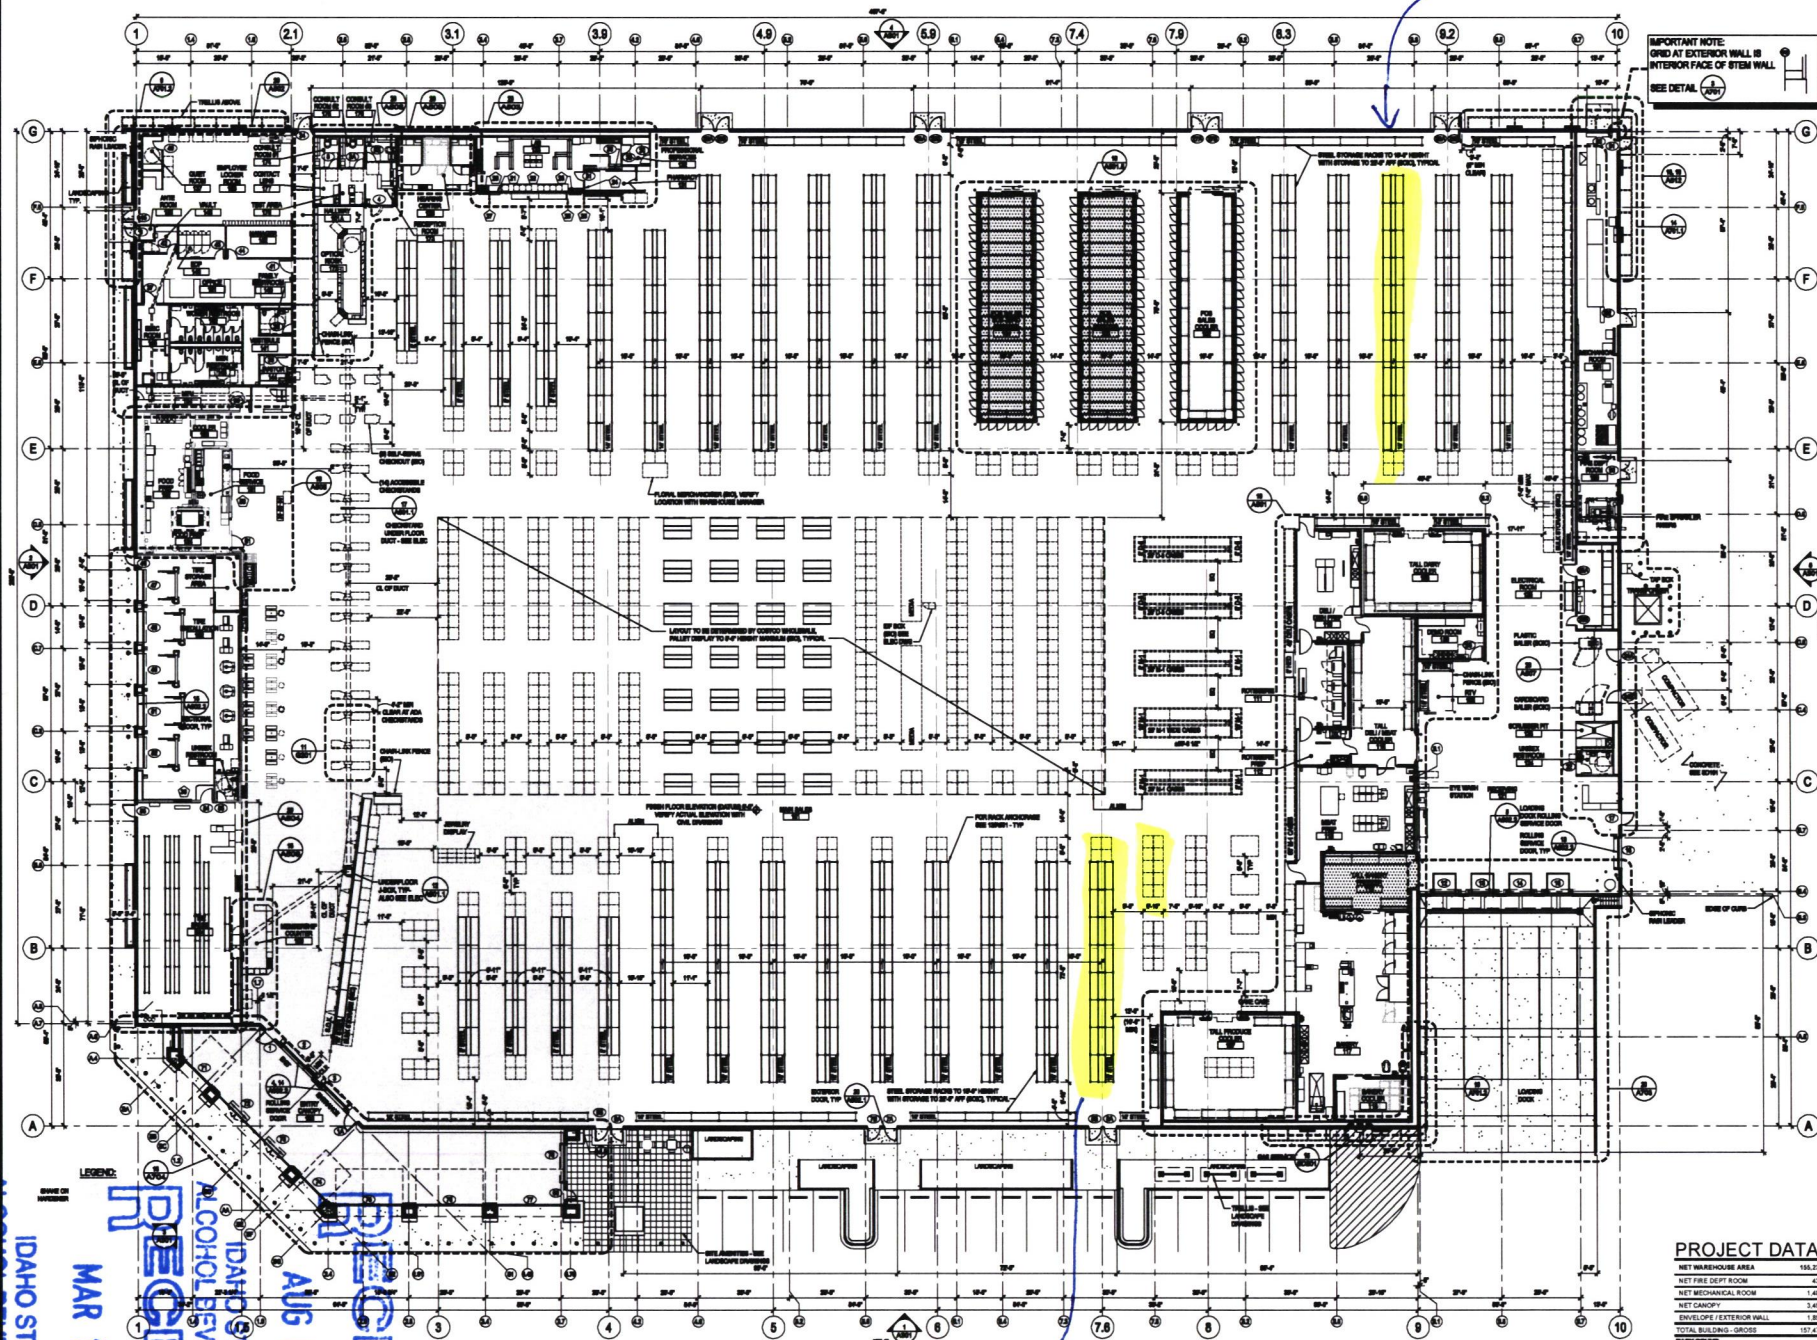


IMPORTANT NOTE:
GRID AT EXTERIOR WALL IS
INTERIOR FACE OF STEM WALL.
SEE DETAIL 1001

Costco WHOLESALE
MERIDIAN, ID
3403 W CHINDEN BLVD
MERIDIAN, ID 83646

COSTCO WHOLESALE CORPORATION
999 LAKE DRIVE
ISSAQUAH, WA 98027
T. 425.313.8100
WWW.COSTCO.COM

MG3
BID SET

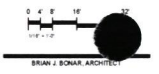

DATE	DESCRIPTION
01.15.18	OWNER APPROVAL
01.13.20	PERMIT ISSUE
01.09.20	BD ISSUE
	AS-BUILT ISSUE

PROJECT DATA

NET WAREHOUSE AREA	156,222 SF
NET FREE DEPT ROOM	4,000 SF
NET MECHANICAL ROOM	1,488 SF
NET CANOPY	3,488 SF
NET ENVELOPE / EXTERIOR WALL	1,800 SF
TOTAL BUILDING - GROSS	157,474 SF

WINE COUNT:	
GROCCERY BACKS (15 R)	275
GROCCERY PALETS	134
CENTER SECTION	18,858 SF
HARDWARE BACKS (15 R)	13
HARDWARE PALETS	13

NOTES

NOTE:
ADD ADDITIONAL INSULATION AT PLUMBING LOCATED
AGAINST THE EXTERIOR WALL - SEE 17 / A101

FLOOR PLAN
SCALE: 1/16" = 1'-0"

NOTE:
LOCATE KNOX BOXES AS DIRECTED BY FIRE DEPT
HAVE PROVISIONS TO Tie INTO SECURITY SYSTEM

NOTE:
TO DETERMINE DOOR OPENING SIZE, SEE DOOR
SCHEDULE ON A102 AND DETAILS ON A102.2 AND A102.3

NOTE:
SEE G003 FOR
STORAGE LOCATIONS

FLOOR PLAN

A101

RECEIVED
AUG 06 2020
IDAHO STATE POLICE
ALCOHOL BEVERAGE CONTROL
MAR 19 2020
IDAHO STATE POLICE
ALCOHOL BEVERAGE CONTROL