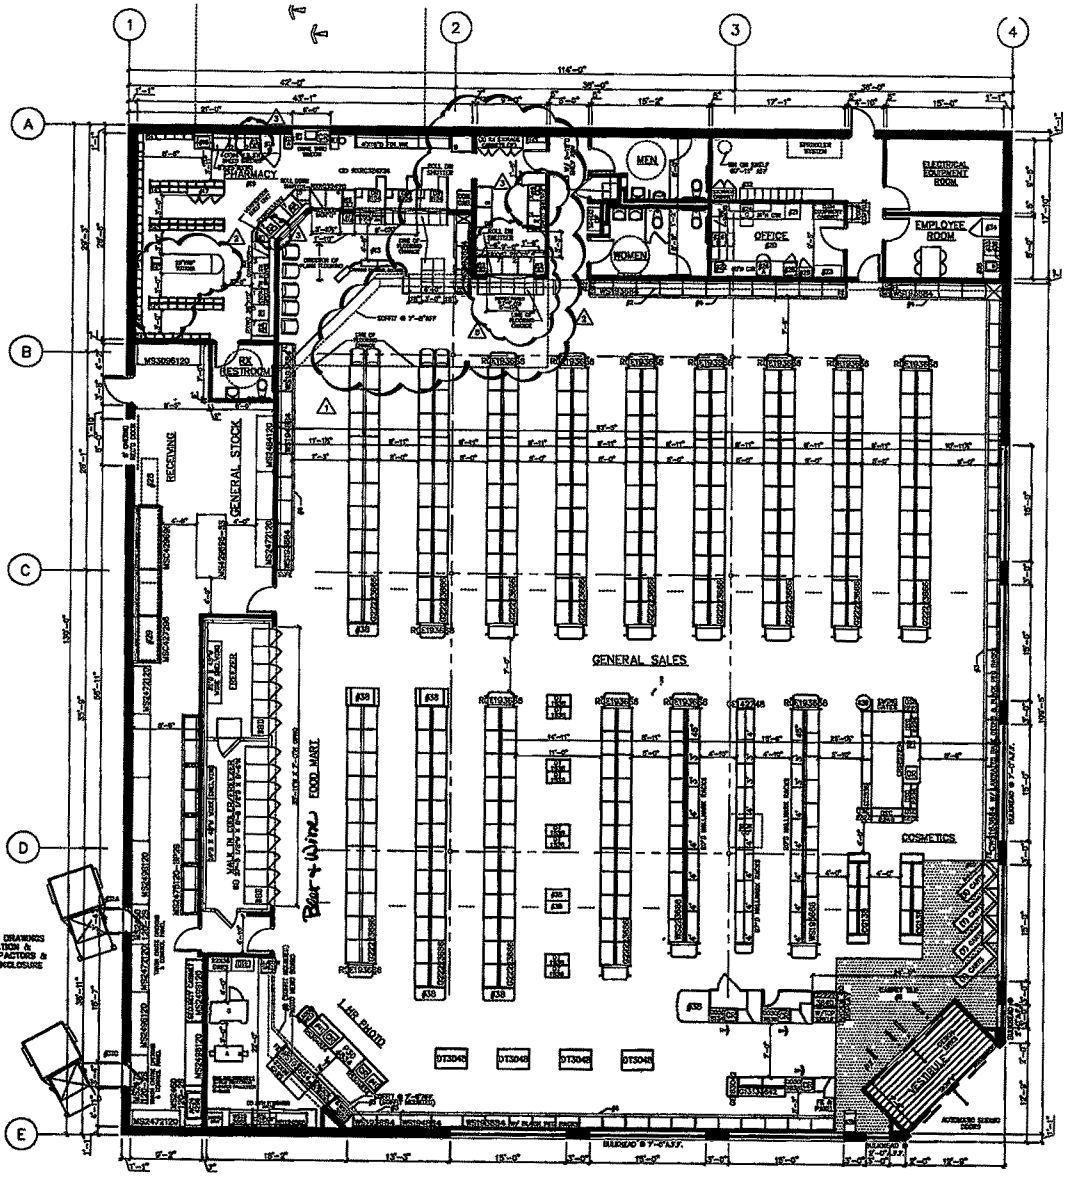

PLEASE NOTE:
DROP OFF GRAPHIC TO BE APPLIED TO MIRRORS
(INDIVIDUAL LETTERS)

PHARMACY DEPARTMENT:
REFER TO FIXTURE PLAN FOR REQUIRED SIGNS
SIGN "P" PICK UP PRESCRIPTIONS
SIGN "K" DROP OFF PRESCRIPTIONS
SIGN "C" CONSULTATION WINDOW
SIGN "TX" T.A.D.
SIGN "ADA" SYMBOL OF ACCESSIBILITY

ATTACH SIGNS TO UNDERSIDE OF GASED OPENINGS. REFER TO FIXTURE PLAN FOR SIGN LOCATION. PROVIDE (2) HOLLOW WALL ANCHORS PER SIGN. SCREW THREADED EYEBOLT INTO ANCHOR. HANG SIGNS FROM EYEBOLTS WITH "S" HOOKS.

GENERAL NOTES

GENERAL SALES AREA:
1. PLEASE PROVIDE PROPER A.D.A. CLEARANCES ON BOTH SIDES OF ALL DOORS
2. MIRROR ON REAR WALL
3. COSMETIC CORNOR
4. SALES AREA CORNOR (FIXTURE MOUNTED)
5. PHOTO CORNOR (FIXTURE) MTD UNLESS NOTED)
6. CARPET TILES & DESIGN LINES FURNISHED AND INSTALLED BY WALGREENS (WHEN SHOWN)
7. MASTER-BILT REACH-IN REFRIGERATOR: (PROVIDE 2" AIR SPACE BETWEEN COOLERS AND FREEZERS)
OPEN FRONT, MEDIUM TEMP. COOLERS (ADD 2" AT EACH END, FOR END PANELS)
A. ___ MD-OS: 8-0"W X 42 DEP
B. ___ MD-OS: 5-0"W X 42 DEP
MODEL SEL-EKOLESS REACH-IN FREEZERS (ADD 3" AT EACH END, FOR END PANELS)
C. ___ SES-S-24: 6'-0 SS"W X 87 SH"
D. ___ TAF-48HD: 52"W X 36 SH"
E. ___ SMS-250 WIRE COOLER: 70"W X 82"D X 78.5"H
8. MASTER-BILT WALK-IN COOLER: PROVIDE
9 #1000R COOLMASTER DOORS
35 36" X 78" EACH AND
6 #1001FA FREEZERMASTER DOORS
35 36" X 78" EACH BY ANTHONY
A. ___ DOOR(S) FOR EACH DOOR PROVIDE
(7) __ D SEV-O-LOW GRAVITY SHELVES; UPPER (5) WITH SLIDES AND LOWER (2) WITH ROLLERS COMPLETE WITH UPRIGHTS
B. ___ DOOR(S) FOR EACH DOOR PROVIDE
30"D B-A-F NYLA-LITE SHELVING SYSTEM
C. 9 DOOR(S) __ D ROLLER CONVEYOR AT FLOOR LEVEL
D. 6 DOOR(S) FOR EACH DOOR PROVIDE
27"D ANTHONY SHELVES
E. ___ DOOR(S) FOR EACH DOOR PROVIDE
(2) 27"D ANTHONY SHELVES AND (4) 30"D MERCHANDISER SHELVES
F. ___ DOOR(S) __ D DOUBLE DECK ROLLER CONVEYOR
9. RX CHEST BY VENDOR
10. CRIT RAILS W/ DISPLAY SHELF & CLAT WALL ABOVE
11. PROVIDE A 6"H BLACK VINYL BASE AT ALL CHECKOUTS
12. ELECTRONIC ARTICLE SURVEILLANCE SYSTEM

PHARMACY DEPARTMENT:
13. PATIENT SEATING AREA: (6) SEATS
14. PROVIDE ELECTRIC FOR FUTURE ROBOTICS
15. COMPUTER TERMINAL
15A: BITCROOM PLUS TERMINAL
15C: TRAINING TERMINAL (IN TRAINING ROOM)
16. RX SINK AND CABINET
17. CRX CABINET
18. RX REFRIGERATOR
19. PROVIDE A CARPETED FLOOR WITH A RUBBER RUNNER. RX UNDERCOUNTER INSERTS:
#1 - RX 3 DRAWER VIAL INSERT
#2 - RX 5 DRAWER FILE INSERT
#3 - RX OPEN INSERT
#4 - RX CONSULTATION COUNTER UNIT
#5 - RX PRINTER INSERT
#6 - RX 5 DRAWER FILE INSERT
#7 - RX OPEN INSERT WITH CPU SHELF
#8 - RX OPEN CABINET
#9 - RX 10 DRAWER FILE CABINET

OFFICE:
20. PROVIDE TILED FLOOR & VINYL WALLCOVERING
21. UNDER COUNTER SHELF UNIT
22. PRINTER
23. LATERAL FILE
24. OFFICE COMPUTERS
24A: P.O.S. TERMINAL
24B: AS400 TERMINAL
24C: OFFICE P.C.
25. TELL LOCKER
26. SAFE
27. TV & VCR (IN TRAINING ROOM)

STOCKROOM:
28. KEEP-A-FLEX CONVEYOR
29. GRAVITY CONVEYOR
30. POWER ROLLER CONVEYOR
31. SEE ARCHITECTURAL DRAWINGS FOR EXACT LOCATION & POSITIONING OF COMPACTORS
31A: TRASH COMPACTOR
31B: BALER
31C: CARDBOARD COMPACTOR

EMPLOYEE ROOM:
32. EMPLOYEE LOCKERS: (1) 48"W LOCKER W/ PERFORATED DOORS, (5) 6 TIER BOX LOCKERS & (2) ADA LOCKERS W/ SAFETY VIEW DOORS
33. 6'-0"W X 2'-0" EMPLOYEE COUNTER W/ (1) CABINET
34. EMPLOYEE ROOM REFRIGERATOR (PROVIDE 32" CLEARANCE WHEN NEXT TO COUNTER)
35. EMPLOYEE ROOM SINK (IN COUNTER)
36. 4'-0" MIRROR CENTERED ON WALL ABOVE COUNTER

MISCELLANEOUS:
37. "R" - ELECTRICAL OUTLET FOR FUTURES USE
38. VENDOR RACKS: REMOVE BASE DECK & SHOES; (TAD PANEL TO REMAIN)
39. PROVIDE OPENING FOR ONE-WAY GLASS (SEE INTERIOR ELEVATION FOR LOCATION)
40. NEWSPAPER RACK BY VENDOR
41. PICTURE CARS PLUS TERMINAL

NEW LOCATION	■	PHARMACY	■	SEQUIOIA	
REMODEL	☐	1 HOUR PHOTO	■	24 HOUR STORE	■
		LIQUOR	☐	OTHER	☐

SQUARE FOOT AREA SUMMARY

DEPARTMENT		SALES	STOCK	SERVICE	TOTAL EXISTG	TOTAL NEW
GEN SALES	NEW	9432	1772	1194		12,398
	EXISTG					
FOOD MART	NEW	900				900
	EXISTG					
RX	NEW	833				833
	EXISTG					
RX WAITG	NEW	204				204
	EXISTG					
1 HOUR PHOTO	NEW	438				438
	EXISTG					
LIQUOR	NEW					
	EXISTG					
DGMT	NEW					
	EXISTG					
2ND FLOOR	NEW					
	EXISTG					
TOTAL NEW		11,804	1772	1194		14,770
TOTAL EXISTG						
TOTAL AREA: FIRST FLOOR						14,770 SQ.FT.
TOTAL AREA: OTHER LEVELS						SQ.FT
GROSS AREA INCLUDING ALL DEPARTMENTS & ALL LEVELS:						14,770 SQ.FT
RX SHELVING LINEAL FEET:		EXISTING 95		NEW 96		191 LIN.FT

NO.	DATE	BY	DESCRIPTION	CON
5	01/06/07	DN	REVISED DROP OFF FIXTURE AND SIGNS	
4	12/26/07	DN	ADDED NOTE FOR DROP OFF GRAPHIC APPLIED TO MIRRORS (INDIVIDUAL LETTERS)	
3	10/26/07	DN	REMOVED STORAGE CAGE AND REPLACED WITH WC CORNER RX INSERTS AND A DPL, SIGNS & EP. AT VERIFICATION WINDOW AND BACK WC COUNTER	
2	10/24/07	DN	ADDING DOOR TO BE ADD AND SPEC CX-2007, ADDING TRASH TO BALEROOM, RX AND CARPET FOR NEW RX INSERTS, TURN WALL DOWN FOR NEW RX INSERTS, TURN WALL TOWARD 12 IN INSTALLED LEDGES	
1	10/22/07	DN	REVISED RX CLOSET, REMOVE SEATING, REMOVE CARPET, ADD 1 HOUR PHOTO, REMOVE "CRX" WALL AND ADD WALL SHELVING	

REVISIONS

CERTIFICATION AND SEAL

I HEREBY CERTIFY THAT THIS PLAN AND SPECIFICATION WAS PREPARED BY ME OR UNDER MY DIRECT SUPERVISION AND THAT I AM A DULY REGISTERED ARCHITECT OR ENGINEER UNDER THE LAWS OF THE STATE OF IDAHO AS SIGNIFIED BY MY HAND AND SEAL.

STORE NUMBER 10603

PROJECT NAME
WALGREENS STORE
(NWC) AMMON AND 17TH
AMMON, IDAHO

OPEN 24 HOURS

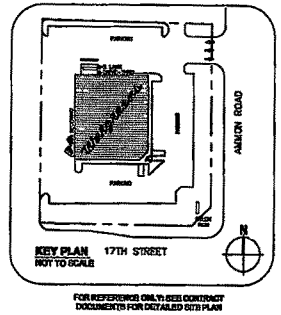

FOR REFERENCE ONLY! SEE CONTRACT DOCUMENTS FOR DETAILED SITE PLAN

TOTAL BY LINEAL FOOTAGE	1310 LN. FT.
FRONT WALL SHELVING (INCLUDE 9" HIGH WALLAT PHOTO)	78 LN. FT.
COSMETIC WALL SHELVING	78 LN. FT.
REMAINING WALL SHELVING (BACK & SIDE WALL, RX SEATING)	101 LN. FT.
BACK GONDOLAS	594 LN. FT.
FRONT GONDOLAS	459 LN. FT.

*A.D.A. DOOR CLEARANCES

*ACCESSIBILITY REQUIREMENTS MAY VARY WITH LOCAL JURISDICTIONS & APPROACH TO DOOR SWING

EXECUTIVE APPROVAL		DATE
SENIOR VICE PRESIDENT FACILITIES DEVELOPMENT		
SENIOR VICE PRESIDENT STORE OPERATIONS		
VICE PRESIDENT STORE OPERATIONS		
REVIEWED BY:	C. CLESLE 12/1/05	C. EKDREN 12/1/05

PROTOTYPE

FIXTURE LEGEND					
G GONDOLA (DA. SIDE)	13\13 D.	30 W.	66* H.	ALL OTHER FIXTURES ARE TYPICALLY CALLED OUT DEPTH BY WIDTH. EXAMPLE:	
GI GONDOLA END	18 D.	30 W.	66* H.		
WG WALL SHVNG	18 D.	36 W.	84* H.	GT DISPLAY TABLE	30 D. 42 W.

*DOES NOT INCLUDE STANDARDS, WOOD GROUNDS OR FINISHED END PANELS

DRAWING TITLE
FIXTURE FLOOR PLAN

CADD PLOT: 10603-D1-06-0080NW
VOID PLOT: 10603-01-07-2000NW
SUPERSEDES PLAN DATED:

SCALE: 1/8"=1'-0"
DRAWN BY: B. LEVINE
DATE: 01/01/06
REVIEWED BY:

DRAWING NO. D1
OF DWGS.